

**Lee County Board Of County Commissioners
Agenda Item Summary**

Blue Sheet No. 20040161

1. REQUESTED MOTION:

ACTION REQUESTED: Request Board authorize elimination of non-viable project alternatives from further consideration in the Project Development and Environment (PD&E) study for County Road 951 as shown on the attached graphic in red. Authorize DRMP, Inc. to proceed with further study of the initial project alternatives as shown in green on the attached graphic.

WHY ACTION IS NECESSARY: Board of County Commissioners must adopt proposed county roadway alignments.

WHAT ACTION ACCOMPLISHES: Allows DRMP, Inc. to proceed with the PD&E study.

2. DEPARTMENTAL CATEGORY:
COMMISSION DISTRICT # 3, 5

C9A

3. MEETING DATE:

02-24-2004

4. AGENDA:

- CONSENT
- ADMINISTRATIVE
- APPEALS
- PUBLIC
- WALK ON
- TIME REQUIRED:

5. REQUIREMENT/PURPOSE:
(Specify)

- STATUTE
- ORDINANCE
- ADMIN.
- CODE
- OTHER

6. REQUESTOR OF INFORMATION:

- A. COMMISSIONER
- B. DEPARTMENT Transportation
- C. DIVISION

BY: Scott M. Gilbertson

7. BACKGROUND:

Board Authorized the CR 951 PD&E study on 8/20/2002. The alignments shown on the attached graphic (both green and red) are the sum of all the alignment suggestions received from the PD&E team and the public within the project study area. These alignments were reviewed by the project team for travel service and safety (through evaluation of the long range transportation model), environmental impacts, both natural and social/cultural, as well as project cost. After compiling and analyzing the data from this review process the project team is recommending to the BoCC that the alignments in red be eliminated from further study based upon the comparative results of those factors.

8. MANAGEMENT RECOMMENDATIONS:

9. RECOMMENDED APPROVAL:


A Department Director	B Purchasing or Contracts	C Human Resources	D Other	E County Attorney	F Budget Services	G County Manager
<i>2/10/04</i> <i>[Signature]</i>				<i>[Signature]</i>	<i>Agm 2/10/04</i> <i>OM 2/11/04</i> <i>Risk 2/12/04</i> <i>GC 2/11/04</i>	<i>[Signature]</i> <i>2-11-04</i>

10. COMMISSION ACTION:

- APPROVED
- DENIED
- DEFERRED
- OTHER

Rec. by CoAtty
Date: *2/11/04*
Time: *2:35 PM*
Forwarded To: *[Signature]*

RECEIVED BY
COUNTY ADMIN: *[Signature]*
2/10/04
3:10 pm SLT
COUNTY ADMIN
FORWARDED TO: *[Signature]*
2/12/04
4 PM

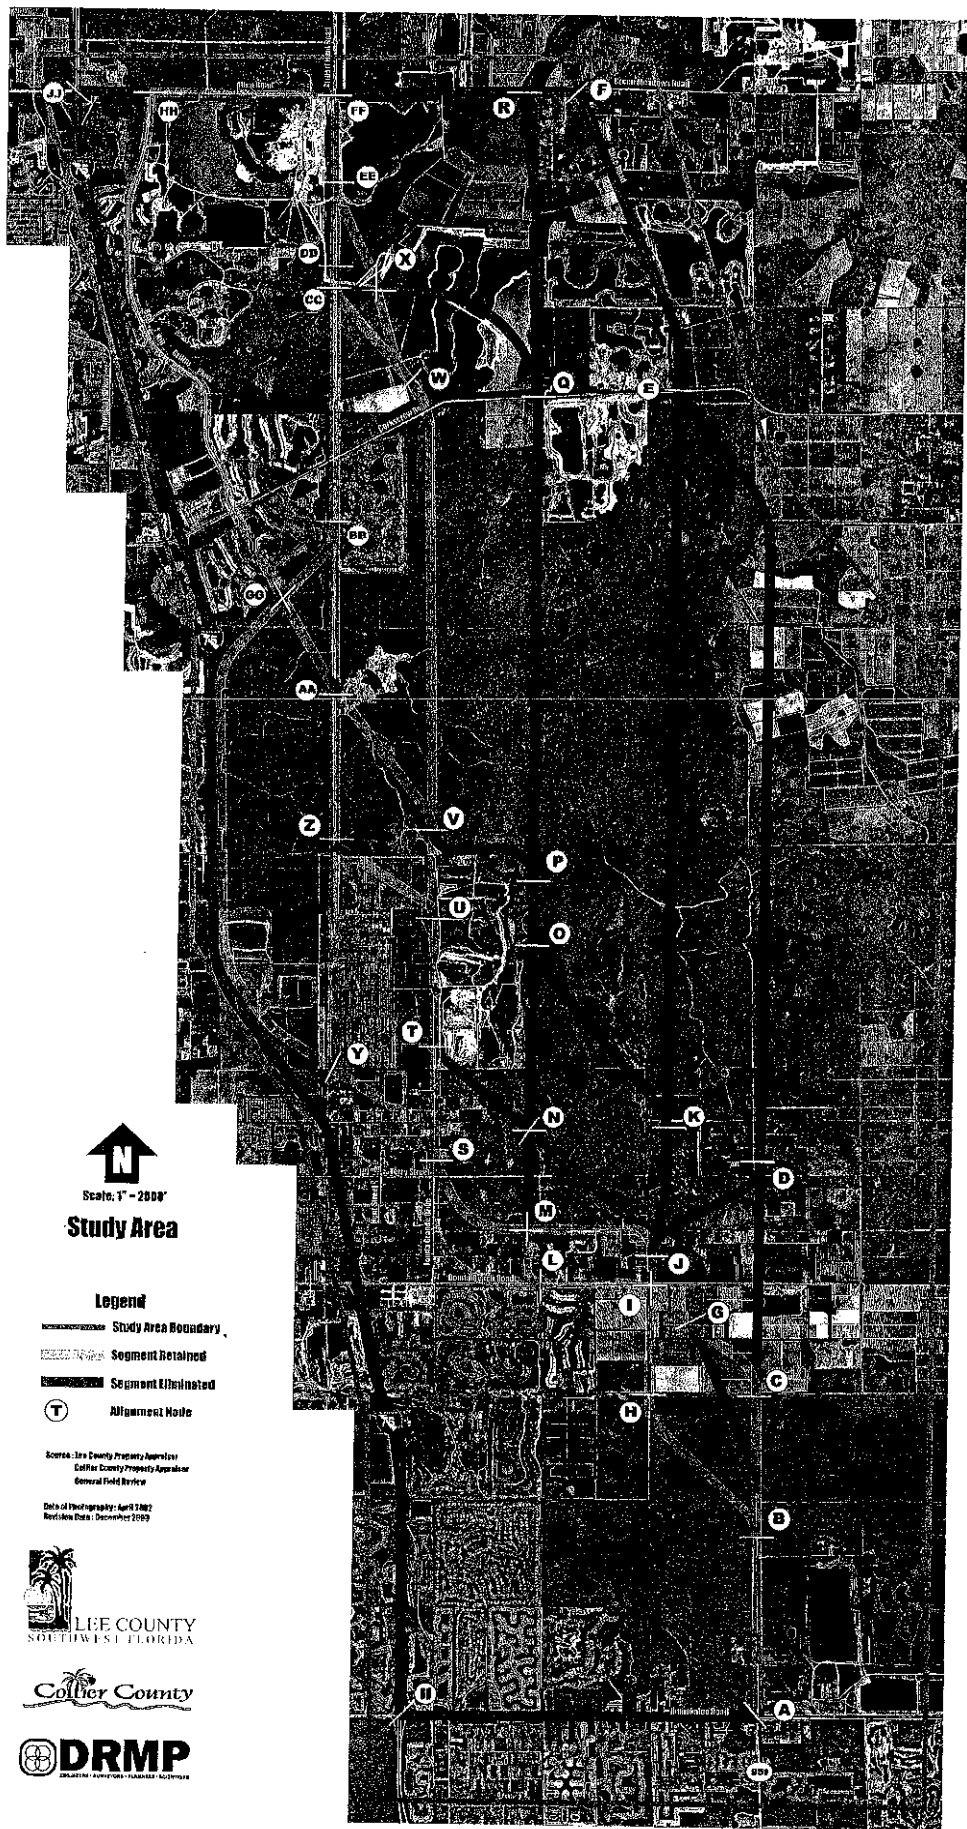

Scale: 1" = 2000'

Study Area

Legend

-  Study Area Boundary
-  Segment Retained
-  Segment to be Eliminated
-  Alignment Node

Source: Lee County Property Appraiser
 Collier County Property Appraiser
 General Field Review

Date of Photography: April 2002
 Revision Date: December 2009



C.R. 951 Project Development & Environment Study